



TOWNSHIP No. IV RANGE No. II.

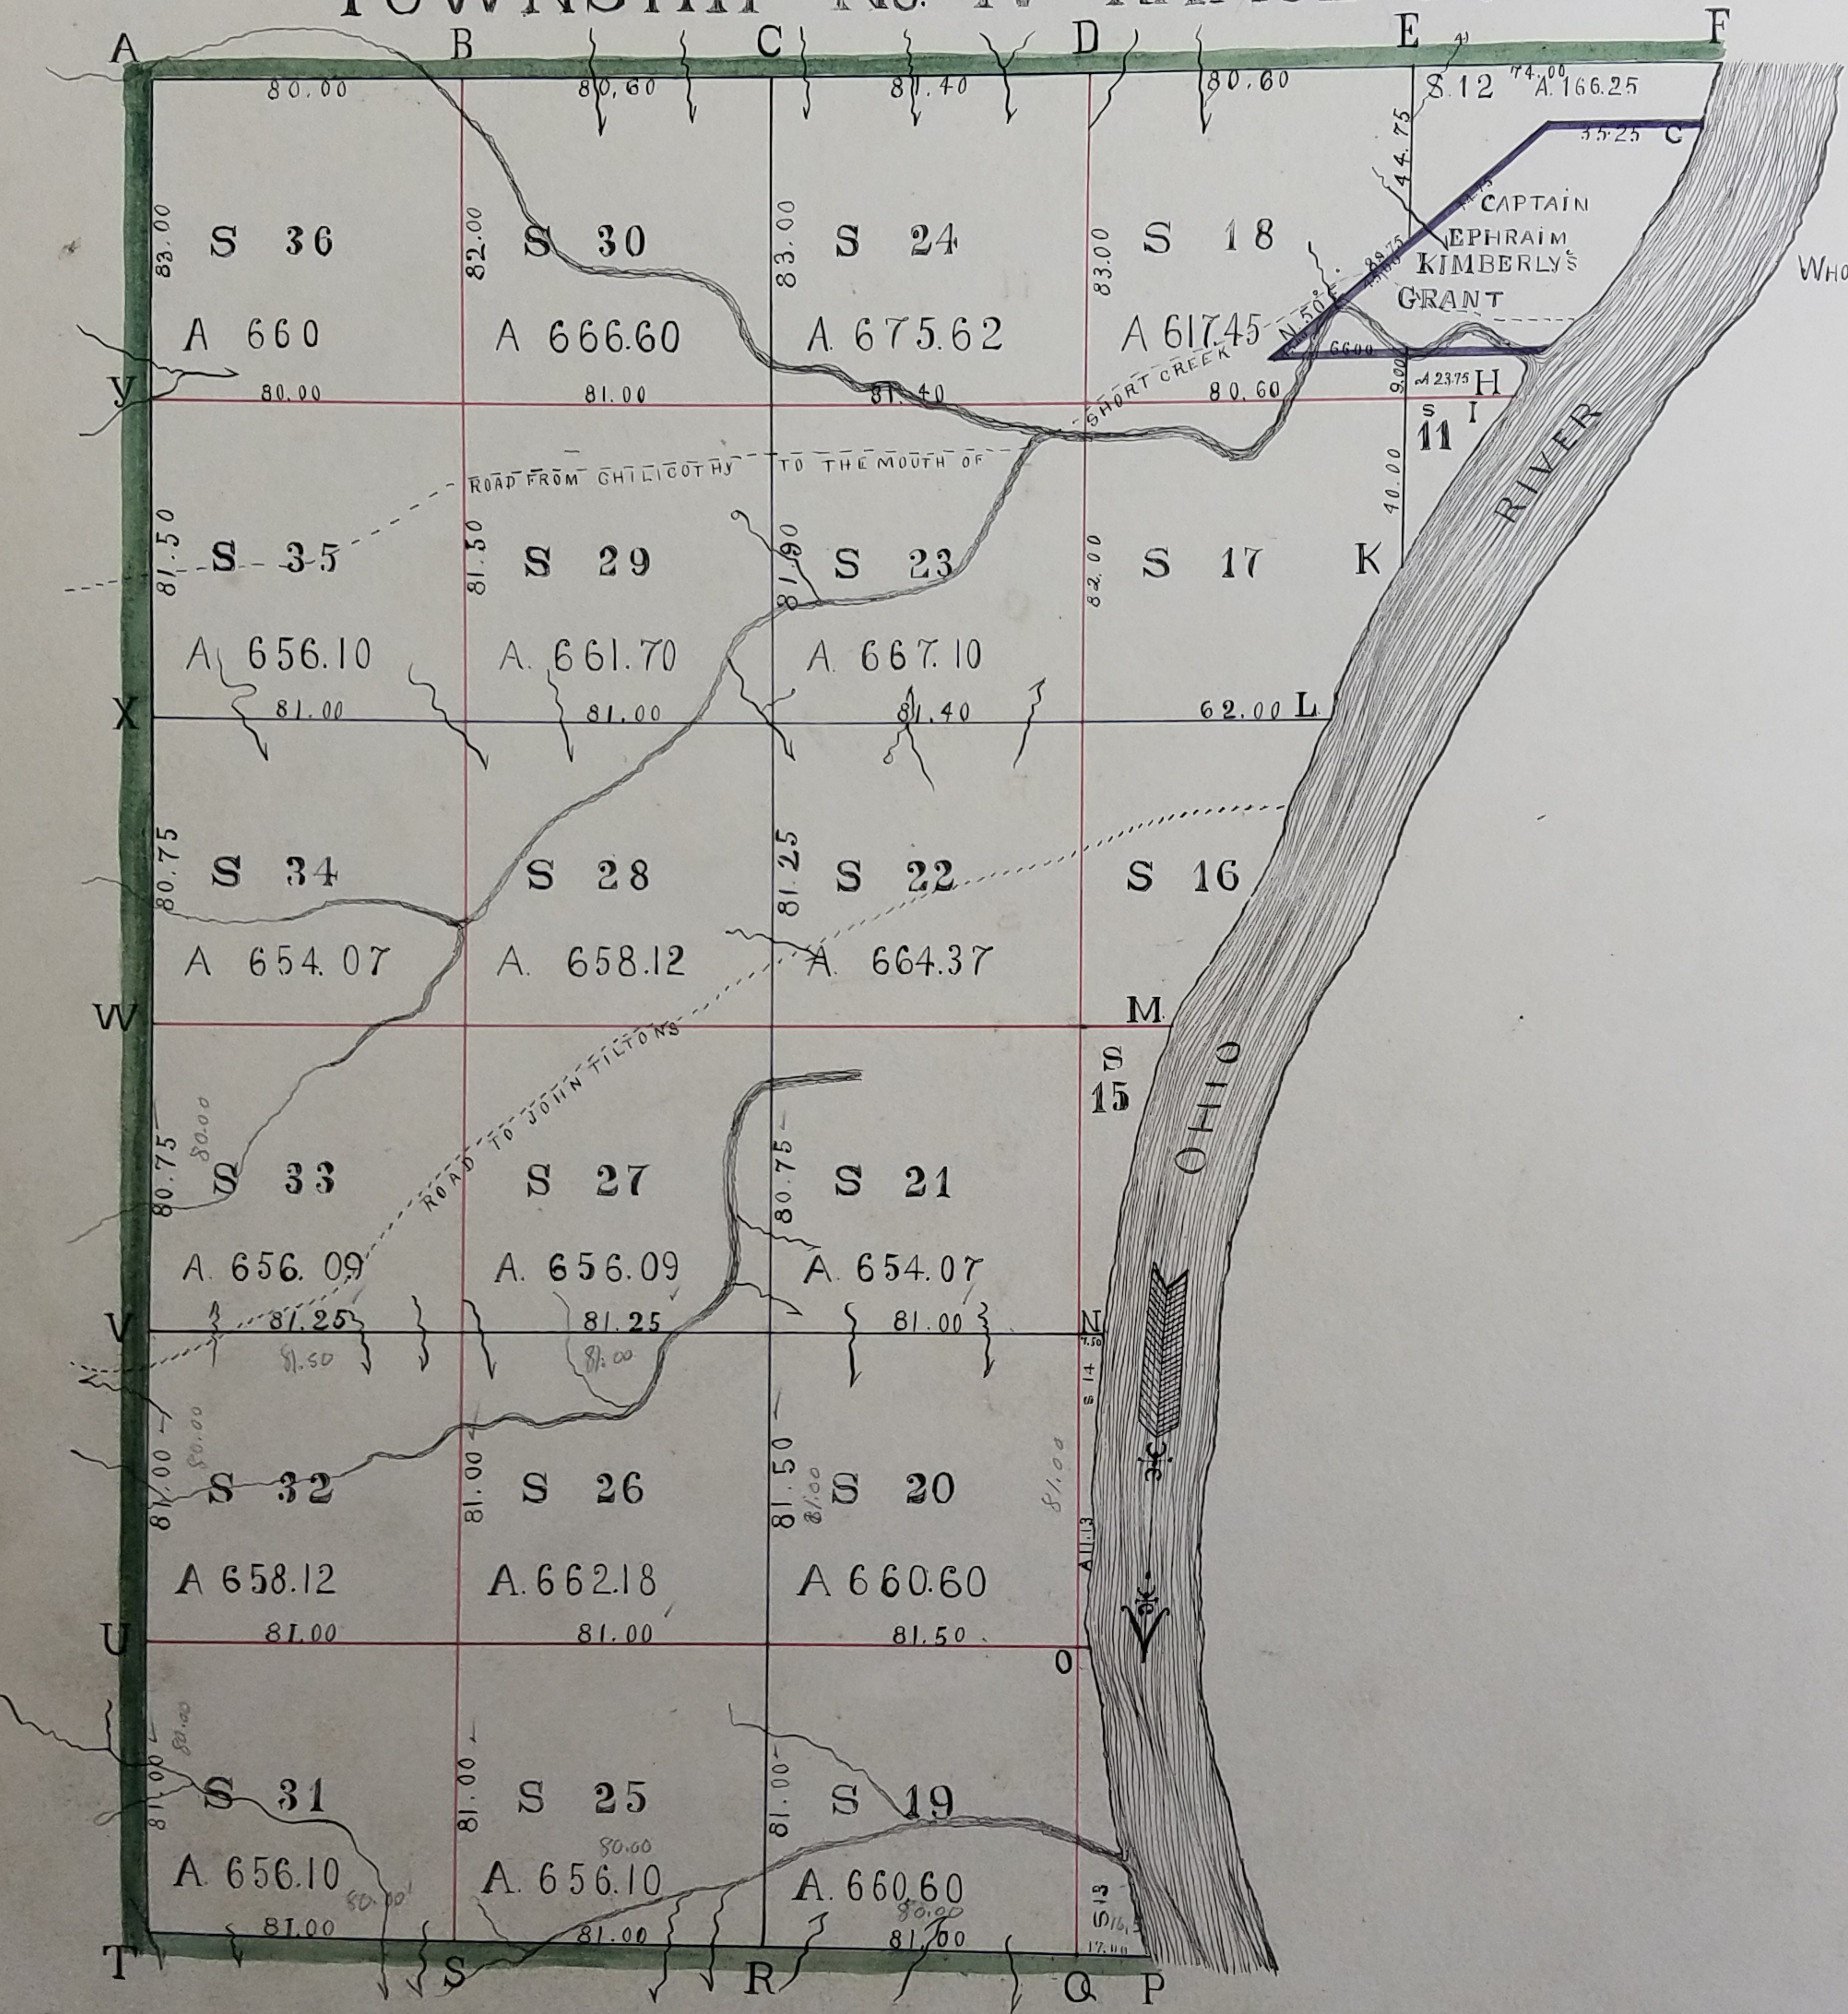

WHOLE CONTENT OF SECTION No. 12 ACRES 190-

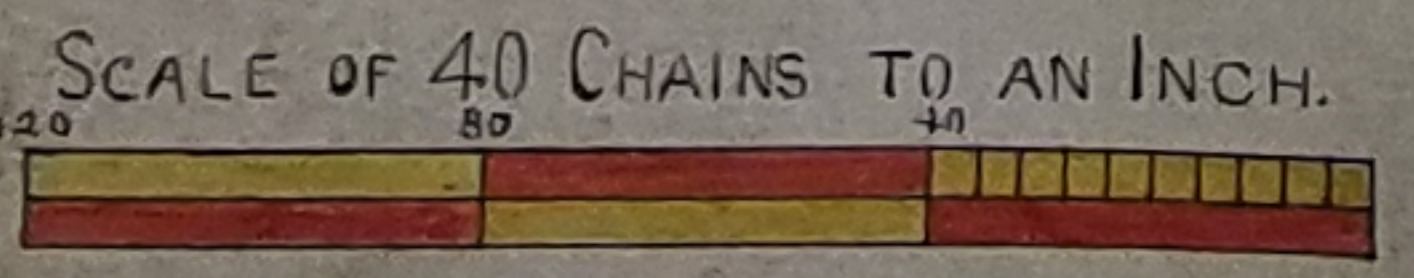

A TRUE COPY
DAVID HOCE, REQ.

A TRUE COPY
BY
JOHN A BOND
1894

DESCRIPTION OF TOWNSHIP No. IV RANGE No. II.

POSTS	BEARING TREES	INCHES DIAM.	COURSE THEY BEAR	LINKS DISTANT	POSTS	BEARING TREES	INCHES DIAM.	COURSE THEY BEAR	LINKS DISTANT
A	SUGARTREE	10	S 70 E	04½	N	SUGARTREE	24	S 2 E	38
	W. WALNUT	15	N 6½ W	37		DO	10	N 15 W	45
B	BEECH	12	N 34 W	35	O	---	---	---	---
	SUGARTREE	11	S 40 E	40	P	ELM	10	N 2 E	119
C	HICKORY	14	N 33 E	07		DO	30	S 16 W	219
	B. OAK		S 27 W	09	Q	BEECH	08	CORNER TREE	
D	SUGARTREE	12	S 4½ E	18		SUGARTREE	26	S 31 W	08
	W. OAK	14	N 13 W	39		BEECH	14	N 21 E	26
E	BEECH	19	S 54 E	11	R	DO	10	S 50 E	07
	DO	20	N 42 W	44		DO	10	N 32 W	24
	SUGARTREE	04	CORNER TREE		S	HICKORY	10	S 52 E	25
F	W. OAK	20	N 28 E	94		BEECH	07	N 05 W	16
	W. WALNUT	20	S 21 W	34	T	DO	12	N 11 E	08
	SUGARTREE	20	CORNER TREE			DO	12	N 58 W	20
G	LOCUST	07	S 5 E	25	U	DO	18	S 54 W	24
	SUGARTREE	24	N 31 E	18		DO	12	N 17 E	45
H	SYCAMORE	48	CORNER TREE		V	HICKORY	13	N 76½ W	33
	WALNUT	36	S 40 W	14		ASH	07	S 40 E	23
	ELM	36	N 71 E	27	W	DO	06	CORNER TREE	
I	LOCUST	20	CORNER TREE			SUGARTREE	09	S 68 E	24
	SYCAMORE	20	S 30 E	66		WALNUT	10	N 56 W	25
	LOCUST	07	N 36 E	57	X	W. OAK	30	CORNER TREE	
K	ASH	06	CORNER TREE			SUGARTREE	12	N 2 E	25
	SYCAMORE	15	S 61 E	19		HICKORY	08	S 50 E	36
	WALNUT	30	WEST	04	Y	SUGARTREE	15	CORNER TREE	
L	SUGARTREE	36	N 50 E	17		B. OAK	18	S 89 E	45
	DO	24	S 25 W	222		BEECH	14	S 34 W	52
M									

A TRUE COPY
BY
JOHN A. BOND
1894

INTERIOR SECTION CORNERS BLACK-LINES.

SECTION CORNERS	BEARING TREES	INCHES DIAM.	COURSE THEY BEAR	LINKS DISTANT	SECTION CORNERS	BEARING TREES	INCHES DIAM.	COURSE THEY BEAR	LINKS DISTANT
11 . 12 17 . 18	ELM	16	N 48 E	40	26 . 27 32 . 33	BEECH	12	S 45 W	54
	WALNUT	10	N 74 W	50		DO	07	S 82 E	17
19 . 20 25 . 26	BEECH	06	S 10 E	15	28 . 29 34 . 35	W. OAK	34	S 75 E	17
	DO	16	N 10 W	32		SUGARTREE	08	N 19 W	38
20 . 21 26 . 27	DO	15	N 6 E	22		ON N.E. LINE OF KIMBERLYS GRANT			
	DO	12	S 51 W	23		SUGARTREE	08	N 72 E	07
14 . 15 20 . 21	POPLAR	36	N 69 W	12		DO	05	S 61 W	19
	SUGARTREE	05	S 87 E	45		ON THE SOUTH BOUNDARY OF KIMBERLYS GRANT			
21 . 22 27 . 28	DO	14	N 46 E	27		SYCAMORE	16	S 75 W	61
	DO	13	S 75 W	31		AT THE WEST ANGLE OF KIMBERLYS GRANT			
22 . 23 28 . 29	HICKORY	18	EAST	11		HICKORY	24		
	SUGARTREE	10	WEST	70		SUGARTREE	24		
23 . 24 29 . 30	DO	09	N 23 W	06		AT THE WEST CORNER OF KIMBERLYS GRANT			
	DO	07	S 47 E	38		SUGARTREE	24	CORNER TREE	
	HICKORY	12	CORNER TREE			WALNUT	17	N 56 W	25
16 . 17 22 . 23	SUGARTREE	12	CORNER TREE			DO	18	S 86 E	54
	DO	15	S 5 W	31		---	---	---	---
	BEECH	16	N 54 E	40		---	---	---	---

RED-LINES
TOWNSHIP IV RANGE II CONTINUED.
QUARTER SECTION POSTS DESCRIBED.

QUARTER POSTS	BEARING TREES	INCHES DIAM.	COURSE THEY BEAR	LINKS DISTANT
BETWEEN SECTIONS 30 & 36	BEECH	14	N 37 W	2.50
	NO OTHER TIMBER		NEAR	
29 . 30	SUGARTREE	14	WEST	6.50
	-----	-----	-----	-----

INTERIOR SECTION CORNERS RED-LINES

SECTION CORNERS	BEARING TREES	INCHES DIAM.	COURSE THEY BEAR	LINKS DISTANT
29 . 30 35 . 36	HICKORY	18	S 82 E	15
	WALNUT	10	N 82 W	54
25 . 26 31 . 32	ASH	14	N 57 E	22
	SUGARTREE	09	S 51 W	29
* 13 . 14	BEECH	07	S 26 E	12
	DO	08	N 7 E	19
13 . 14 19 . 20	DO	16	S 4 E	15
	HICKORY	13	N 22 W	24
17 . 18 23 . 24	ELM	24	S 65 W	34
	W. OAK	18	N 60 E	55
	* SEE THE LETTER O IN BOOK			

A TRUE COPY
DAVID HOCE REG.

A TRUE COPY
BY
JOHN A. BOND
1894.